


ORIGINAL

TP-00319

 

NOAA FORM 76-36A (3-72)		U. S. DEPARTMENT OF COMMERCE NATIONAL OCEANIC AND ATMOSPHERIC ADMIN.	
DESCRIPTIVE REPORT - DATA RECORD		TYPE OF SURVEY ☒ ORIGINAL ☐ RESURVEY ☐ REVISED	
PHOTOGRAMMETRIC OFFICE Coastal Mapping Division, Norfolk, VA		SURVEY TP-00319 MAP EDITION NO. (1) MAP CLASS Final (F.E.) JOB PH-7012	
OFFICER-IN-CHARGE Jeffrey G. Carlen, Cdr.		LAST PRECEDING MAP EDITION TYPE OF SURVEY ☐ ORIGINAL ☐ RESURVEY ☐ REVISED JOB PH- MAP CLASS SURVEY DATES: 19__ TO 19__	
I. INSTRUCTIONS DATED			
1. OFFICE		2. FIELD	
Aerotriangulation Jan. 9, 1973 Compilation Feb. 14, 1973		July 18, 1972	
II. DATUMS			
1. HORIZONTAL: ☒ 1927 NORTH AMERICAN		OTHER (Specify)	
2. VERTICAL: ☒ MEAN HIGH-WATER ☒ MEAN LOW-WATER ☐ MEAN LOWER LOW-WATER ☐ MEAN SEA LEVEL		OTHER (Specify)	
3. MAP PROJECTION Polyconic		4. GRID(S) STATE Virginia ZONE North STATE Maryland ZONE	
5. SCALE 1:10,000		STATE Maryland ZONE	
III. HISTORY OF OFFICE OPERATIONS			
OPERATIONS		NAME	DATE
1. AEROTRIANGULATION BY METHOD: Stereoplanigraph LANDMARKS AND AIDS BY		D.M. Brant	Feb. 1973
2. CONTROL AND BRIDGE POINTS PLOTTED BY METHOD: Coradomat CHECKED BY		Coradomat	
3. STEREOSCOPIC INSTRUMENT PLANIMETRY BY COMPILATION CHECKED BY INSTRUMENT: Wild B-8 CONTOURS BY SCALE: 1:15,000 CHECKED BY		L.O. Neterer, Jr. C.E. Blood NA NA	April 1973 April 1973
4. MANUSCRIPT DELINEATION PLANIMETRY BY CHECKED BY METHOD: Smooth Drafted CONTOURS BY CHECKED BY SCALE: 1:10,000 HYDRO SUPPORT DATA BY CHECKED BY		C.E. Blood R.R. White NA NA C.E. Blood R.R. White	May, 1973 June 1973
5. OFFICE INSPECTION PRIOR TO FIELD EDIT BY		R.R. White	June 1973
6. APPLICATION OF FIELD EDIT DATA BY		G.R. Vanderhaven	Feb. 1975
7. COMPILATION SECTION REVIEW BY		A.L. Shands	April 1975
8. FINAL REVIEW BY		A.L. Shands	Jan. 1977
9. DATA FORWARDED TO PHOTOGRAMMETRIC BRANCH BY		A.L. Shands	Mar. 1977
10. DATA EXAMINED IN PHOTOGRAMMETRIC BRANCH BY		J.B. Phillips	Apr. 1977
11. MAP REGISTERED - COASTAL SURVEY SECTION BY		R.T. CATDR	MAY 1977

NOAA FORM 76-36B
(3-72)TP-00319
COMPILATION SOURCESU. S. DEPARTMENT OF COMMERCE
NATIONAL OCEANIC AND ATMOSPHERIC ADMINISTRATION
NATIONAL OCEAN SURVEY

1. COMPILATION PHOTOGRAPHY

CAMERA(S) Wild RC-8 "E"		TYPES OF PHOTOGRAPHY LEGEND (CI) COLOR INFRARED (C) COLOR (P) PANCHROMATIC (I) INFRARED		TIME REFERENCE	
TIDE STAGE REFERENCE ☒ PREDICTED TIDES ☐ REFERENCE STATION RECORDS ☐ TIDE CONTROLLED PHOTOGRAPHY				ZONE Eastern	☒ STANDARD
				MERIDIAN 75 W	☐ DAYLIGHT
NUMBER AND TYPE	DATE	TIME	SCALE	STAGE OF TIDE	
72 E(CI)1597 - 1598	18 APR 72	10:20	1:30,000	2.8 ft. above MLW	
72 E(CI)1599 - 1600	18 APR 72	10:24	1:30,000	2.9 ft. above MLW	
72 E(CI)1644 - 1647	18 APR 72	11:33	1:30,000	2.8 ft. above MLW	

REMARKS

2. SOURCE OF MEAN HIGH-WATER LINE:

The mean high water line was compiled from the color infrared photographs as listed above.

3. SOURCE OF MEAN LOW-WATER OR MEAN LOWER LOW-WATER LINE:

No mean low water line was compiled; no low water photography was available.

4. CONTEMPORARY HYDROGRAPHIC SURVEYS (List only those surveys that are sources for photogrammetric survey information.)

SURVEY NUMBER	DATE(S)	SURVEY COPY USED	SURVEY NUMBER	DATE(S)	SURVEY COPY USED

5. FINAL JUNCTIONS

NORTH	EAST	SOUTH	WEST
TP-00318	No Survey	TP-00322	No Survey

REMARKS

TP-00319

HISTORY OF FIELD OPERATIONS

1. ☒ FIELD INSPECTION OPERATION☐ FIELD EDIT OPERATION

OPERATION	NAME	DATE
1. CHIEF OF FIELD PARTY	R.D. Olson	Oct. 1972
2. HORIZONTAL CONTROL	RECOVERED BY R.D. Olson ESTABLISHED BY None PRE-MARKED OR IDENTIFIED BY R.D. Olson	Oct. 1972
3. VERTICAL CONTROL	RECOVERED BY NA ESTABLISHED BY NA PRE-MARKED OR IDENTIFIED BY NA	
4. LANDMARKS AND AIDS TO NAVIGATION	RECOVERED (Triangulation Stations) BY None LOCATED (Field Methods) BY None IDENTIFIED BY R.D. Olson	Oct. 1972
5. GEOGRAPHIC NAMES INVESTIGATION	TYPE OF INVESTIGATION ☐ COMPLETE ☐ SPECIFIC NAMES ONLY ☒ NO INVESTIGATION	
6. PHOTO INSPECTION	CLARIFICATION OF DETAILS BY None	
7. BOUNDARIES AND LIMITS	SURVEYED OR IDENTIFIED BY NA	

II. SOURCE DATA

1. HORIZONTAL CONTROL IDENTIFIED

2. VERTICAL CONTROL IDENTIFIED
NA

PHOTO NUMBER	STATION NAME	PHOTO NUMBER	STATION DESIGNATION
72E(C1)1597	QUEEN 2, 1959		
72E(C1)1647	TEMPLE, 1934		

3. PHOTO NUMBERS (Clarification of details)

None

4. LANDMARKS AND AIDS TO NAVIGATION IDENTIFIED

PHOTO NUMBER	OBJECT NAME	PHOTO NUMBER	OBJECT NAME
72E(C1)1597	UPPER POTOMAC RIVER LIGHT 88		

5. GEOGRAPHIC NAMES: ☒ REPORT ☐ NONE6. BOUNDARY AND LIMITS: ☐ REPORT ☒ NONE

7. SUPPLEMENTAL MAPS AND PLANS

None

8. OTHER FIELD RECORDS (Sketch books, etc. DO NOT list data submitted to the Geodesy Division)

3 Forms 152 Control Station Identification

NOAA FORM 76-36C
(3-72)U. S. DEPARTMENT OF COMMERCE
NATIONAL OCEANIC AND ATMOSPHERIC ADMINISTRATION
NATIONAL OCEAN SURVEY

TP-00319

HISTORY OF FIELD OPERATIONS

I. ☐ FIELD INSPECTION OPERATION☒ FIELD EDIT OPERATION

OPERATION	NAME	DATE
1. CHIEF OF FIELD PARTY	G.W. Jamerson	Nov. 1974
2. HORIZONTAL CONTROL	RECOVERED BY R.D. Black ESTABLISHED BY None PRE-MARKED OR IDENTIFIED BY None	Nov. 1974
3. VERTICAL CONTROL	RECOVERED BY NA ESTABLISHED BY NA PRE-MARKED OR IDENTIFIED BY NA	
4. LANDMARKS AND AIDS TO NAVIGATION	RECOVERED (Triangulation Stations) BY G.W. Jamerson LOCATED (Field Methods) BY G.W. Jamerson IDENTIFIED BY None	Nov. 1974 Nov. 1974
5. GEOGRAPHIC NAMES INVESTIGATION	TYPE OF INVESTIGATION ☐ COMPLETE ☐ SPECIFIC NAMES ONLY BY ☒ NO INVESTIGATION	
6. PHOTO INSPECTION	CLARIFICATION OF DETAILS BY G.W. Jamerson	Nov. 1974
7. BOUNDARIES AND LIMITS	SURVEYED OR IDENTIFIED BY NA	

II. SOURCE DATA

1. HORIZONTAL CONTROL IDENTIFIED

None

2. VERTICAL CONTROL IDENTIFIED

NA

PHOTO NUMBER

STATION NAME

PHOTO NUMBER

STATION DESIGNATION

3. PHOTO NUMBERS (Clarification of details)

72E (CI) 1597 thru 1600

4. LANDMARKS AND AIDS TO NAVIGATION IDENTIFIED

None

PHOTO NUMBER

OBJECT NAME

PHOTO NUMBER

OBJECT NAME

5. GEOGRAPHIC NAMES:

☐ REPORT☒ NONE

6. BOUNDARY AND LIMITS:

☐ REPORT☒ NONE

7. SUPPLEMENTAL MAPS AND PLANS

None

8. OTHER FIELD RECORDS (Sketch books, etc. DO NOT list data submitted to the Geodesy Division)

1 Field Edit Ozalid

1 Film Copy (With Field Notes)

7 Forms 76-40 Landmarks and Aids

1 Field Edit Report

18 Forms 526 Recovery Notes

NOAA FORM 76-36C
(3-72)

NOAA FORM 76-36D
(3-72)

TP-00319

U. S. DEPARTMENT OF COMMERCE
NATIONAL OCEANIC AND ATMOSPHERIC ADMINISTRATION

RECORD OF SURVEY USE

I. MANUSCRIPT COPIES

COMPILATION STAGES			DATE MANUSCRIPT FORWARDED	
DATA COMPILED	DATE	REMARKS	MARINE CHARTS	HYDRO SUPPORT
Compilation complete pending field edit	May, 1973	Class III Manuscript	6/8/73	6/6/73
Field edit applied Compilation complete	Feb. 1975	Class I Manuscript	4/18/75	
Final Review	Jan. 1977			

II. LANDMARKS AND AIDS TO NAVIGATION

1. REPORTS TO MARINE CHART DIVISION, NAUTICAL DATA BRANCH

NUMBER	CHART LETTER NUMBER ASSIGNED	DATE FORWARDED	REMARKS
1		7/16/75	Landmarks to be deleted
1		7/16/75	Landmarks to be charted
1		7/16/75	Aids to be charted

2. ☒ REPORT TO MARINE CHART DIVISION, COAST PILOT BRANCH. DATE FORWARDED: July 16, 1975
 3. ☐ REPORT TO AERONAUTICAL CHART DIVISION, AERONAUTICAL DATA SECTION. DATE FORWARDED: _____

III. FEDERAL RECORDS CENTER DATA

1. ☒ BRIDGING PHOTOGRAPHS; ☒ DUPLICATE BRIDGING REPORT; ☐ COMPUTER READOUTS.
 2. ☒ CONTROL STATION IDENTIFICATION CARDS; ☒ FORM NOS 76-40 SUBMITTED BY FIELD PARTIES.
 3. ☒ SOURCE DATA (except for Geographic Names Report) AS LISTED IN SECTION II, NOAA FORM 76-36C.
 ACCOUNT FOR EXCEPTIONS:

4. ☐ DATA TO FEDERAL RECORDS CENTER. DATE FORWARDED: May 1977

IV. SURVEY EDITIONS (This section shall be completed each time a new map edition is registered)

SECOND EDITION	SURVEY NUMBER TP - _____ (2)	JOB NUMBER PH - _____	TYPE OF SURVEY ☐ REVISED ☐ RESURVEY MAP CLASS ☐ II. ☐ III. ☐ IV. ☐ V. ☐ FINAL
	DATE OF PHOTOGRAPHY	DATE OF FIELD EDIT	
THIRD EDITION	SURVEY NUMBER TP - _____ (3)	JOB NUMBER PH - _____	TYPE OF SURVEY ☐ REVISED ☐ RESURVEY MAP CLASS ☐ II. ☐ III. ☐ IV. ☐ V. ☐ FINAL
	DATE OF PHOTOGRAPHY	DATE OF FIELD EDIT	
FOURTH EDITION	SURVEY NUMBER TP - _____ (4)	JOB NUMBER PH - _____	TYPE OF SURVEY ☐ REVISED ☐ RESURVEY MAP CLASS ☐ II. ☐ III. ☐ IV. ☐ V. ☐ FINAL
	DATE OF PHOTOGRAPHY	DATE OF FIELD EDIT	

JOB PH-7012

UPPER POTOMAC RIVER

WASHINGTON

38°55'00"

38°56'30"

SUMMARY TO ACCOMPANY

Project PH-7012 covers the upper Potomac River from Maryland Point north to Latitude $38^{\circ} 57' 00''$ at Little Falls Dam. All tributaries emptying into the Potomac along this route were mapped to their headwaters.

There are seventeen 1:10,000 scale maps in this project, the purpose of which is to provide contemporary shoreline in support of hydrographic operations conducted in the area from 1972 to 1974. To better coordinate the shoreline compilation with the scheduling of hydrographic operations, compilation was divided into two parts. The southern half, consisting of ten manuscripts, TP-00323 through TP-00332, was compiled in the Rockville office in 1972. Field edit

Field work prior to compilation was limited to the recovery and identification of horizontal control necessary for bridging. This was done in August through September, 1972.

Field edit was accomplished in July 1973, November 1974, and February 1975. It was applied at AMC at various times between November, 1973 and April, 1975.

Final review of TP-00217, TP-00318 through TP-00322, and TP-00333 was done at AMC in January and February, 1977.

The original stabilene base manuscripts, each 1:10,000 scale, were forwarded to the Rockville office for reproduction of registration copies.

NATIONAL OCEAN SURVEY (NCAA)
TIDES, HOURLY HEIGHTS (FEET)

PAGE 2

WASHINGTON D C

APR 1972 TM 75.00W

DAY OF MONTH

HOURL	12	13	14	15	16	17	18	19	20	21	22
0	4.20	5.16	5.61	6.15	6.87	8.05	7.88	8.11	7.13	4.85	7.18
1	3.98	4.87	5.22	5.62	6.28	7.44	7.39	7.80	7.27	5.80	7.95
2	4.19	4.85	4.96	5.24	5.74	6.88	6.83	7.28	7.06	6.37	8.17
3	5.22	5.55	5.01	5.01	5.33	6.39	6.30	6.73	6.62	6.64	8.00
4	6.41	6.85	6.06	5.30	5.06	6.04	5.89	6.23	6.06	6.60	7.66
5	7.15	7.94	7.43	6.57	5.16	5.75	5.57	5.85	5.59	6.22	7.24
6	7.45	8.32	8.26	7.79	6.25	5.64	5.41	5.56	5.18	5.66	6.79
7	7.41	8.44	8.62	8.44	7.52	6.35	5.72	5.44	4.90	5.11	6.37
8	7.01	8.18	8.59	8.71	8.25	7.36	6.87	5.67	4.76	4.72	6.01
9	6.41	7.53	8.18	8.61	8.57	7.98	7.94	6.50	4.83	4.54	5.72
10	5.76	6.86	7.51	8.15	8.49	8.22	8.48	7.42	5.45	4.76	5.52
11	5.19	6.22	6.78	7.50	8.07	7.95	<u>8.66</u>	7.97	6.38	5.65	5.68
12	4.73	5.76	6.13	6.86	7.46	7.47	8.51	8.16	7.01	6.74	6.50
13	4.45	5.47	5.64	6.30	6.82	6.89	8.06	7.99	7.22	7.38	7.53
14	4.47	5.19	5.25	5.82	6.27	6.35	7.49	7.55	7.24	7.65	8.23
15	5.25	5.18	4.94	5.51	5.90	5.88	6.92	7.01	6.85	7.67	8.56
16	6.53	5.94	4.84	5.21	5.60	5.51	6.46	6.46	6.19	7.43	8.57
17	7.43	7.10	5.61	5.17	5.40	5.25	6.11	6.02	5.64	7.05	8.22
18	7.91	7.85	6.89	5.97	5.74	5.12	5.86	5.67	5.13	6.59	7.66
19	8.01	8.15	7.78	7.20	6.97	5.41	5.70	5.41	4.70	6.17	7.09
20	7.68	8.08	8.12	7.98	8.11	6.43	5.89	5.18	4.28	5.83	6.62
21	7.01	7.58	8.01	8.26	8.55	7.42	6.69	5.18	3.97	5.58	6.25
22	6.29	6.86	7.53	8.09	8.84	7.96	7.63	5.67	3.79	5.62	5.96
23	5.65	6.20	6.83	7.57	8.61	8.07	8.10	6.55	3.95	6.21	5.71

DATUM IS

Subtract 4.26' to refer to MLLW

$$\begin{array}{r} 8.66 \\ 4.40 \\ \hline 4.26 \end{array}$$
 above MLLW

Field work prior to compilation was limited to the recovery and identification of horizontal control necessary for bridging. No report was submitted.

PHOTOGRAMMETRIC PLOT REPORT

Job PH-7012

Upper Potomac River, Maryland - Virginia (Part 2)

February, 1973

21. Area Covered

This report covers an area of the Potomac and Anacostia Rivers south from latitude $38^{\circ}57'00''$ to $38^{\circ}40'00''$ where it joins Part 1 of this project. The job consists of seven (7) 1:10,000 scale sheets (TP-00318 thru TP-00322, TP-00217, and TP-00333).

22. Method

Six (6) strips of photographs (strip 1 and strips 3 thru 6) were bridged using the C-8 Stereoplaingraph and adjusted on the IBM 1620. Strip 2 was bridged on the S.T.K. and adjusted by analytical aerotriangulation methods. All strips were adjusted to field-identified horizontal control stations with the exception of strips 3 and 5, where office-identified control stations were used to supplement the field-identified control. Ties were made between all strips. The sketch shows the location of the strips of photography and the horizontal control stations used in bridging. Common image points were located during bridging between the color infrared photography and the black-and-white infrared photography in order to determine a ratio for the enlargements used in compilation.

Data for the seven (7) 1:10,000 scale compilation sheets were plotted by the Coradomat 21 Plotter on the Maryland and Virginia (north zone) coordinate system.

23. Adequacy of Control

All horizontal control used in the adjustment was field identified, except for the following stations:

WOODBRIDGE Relay Mast 1957

BELLEVUE D.C. Fire Dept. Training Center Tank 1970

ALEXANDRIA Washington Masonic Nat. Memorial 1934

These office-identified stations were used only because they provided a better balance of control for the adjustment.

In general, the identification of horizontal control stations (sub points) was poor. Also, the mathematical solutions for the sub points were very poor because of small angles involved in computing azimuths. Horizontal control was adequate.

24. Supplemental Data

USGS quadrangles were used to provide vertical control for the strip adjustments.

2

25. Photography

The following RC-8 color infrared photography (E camera) was used for bridging and the black-and-white infrared (K camera) was flown in tandem with the E camera:

1:30,000 scale photography

strip 1	72 E(c) 1624R	thru	1631R
	72 K 7254R		7262R
strip 2	72 E(c) 1615R	thru	1621R
	72 K 7245R		7252R
strip 3	72 E(c) 1594R	thru	1601R
	72 K 7225R		7232R
strip 4	72 E(c) 1644R	thru	1649R
	72 K 7275		7279R
strip 5	72 E(c) 1654	thru	1666R
	72 K 7285		7297R
strip 6	72 E(c) 1649R	thru	1655R
	72 K 7280R		7236R

Photography was adequate as to coverage, overlap, and identification.

Submitted by

Donald M. Brant

Approved by:

John D. Perrow, Jr.


Chief, Aerotriangulation Section

JOB PH-7012 PART 2

UPPER POTOMAC RIVER MARYLAND-VIRGINIA

SHORELINE MAPPING

SCALE 1:10000

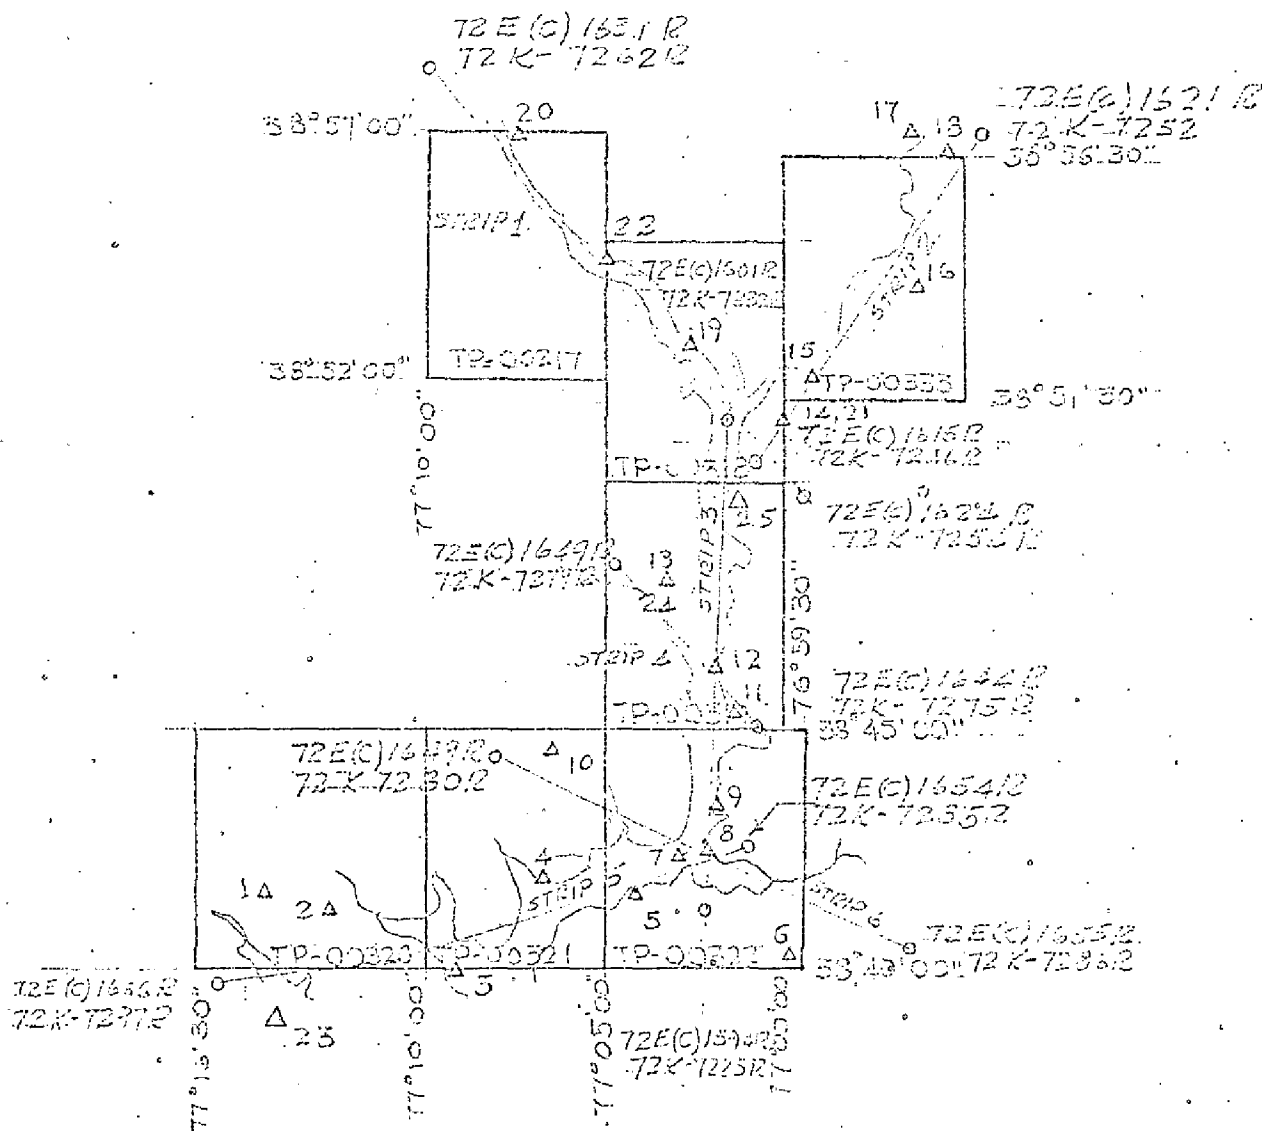

LEGEND

- △ HORIZONTAL CONTROL (USED IN BRIDGING)
- 1:50,000 SCALE COLOR INCREASED (FOR COPIES)
- 1:50,000 SCALE BLACK & WHITE INCREASED
- KEY TO CONTROL ON PAGE 2

JOB PH-7012

KEY TO HORIZONTAL CONTROL
USED FOR BRIDGING

1. OCCOQUAN PENAL INST. STAND PIPE 1959
2. OX 1959
3. WIG 1934
4. FERRY POINT 1959
5. BRYAN 2 1928
6. BEALLE RM 5 1957
7. UPPER POTOMAC RIVER LIGHT 77 1959
8. FORT 1928
9. RIVERVIEW WHARF LIGHT 82 1959
10. GUM SPRINGS RAD. STA. WPIK MAST 1969
11. QUEEN 2 1959
12. UPPER POTOMAC RIVER LIGHT 88 1959
13. TEMPLE 1934
14. ST. ELIZABETH'S INSANE ASYLUM RED STACK 1934
15. SE 154 A 1960
16. NE 146 C
17. HYATTSVILLE RAD. STA. KGA 361 MAST 1970
18. ROGER HEIGHTS STAND PIPE 1952
19. GATE 2 1970
20. MAP AMS 1952
21. INSANE 1912
22. ST. PATRICKS EPISCOPAL CHURCH BELL TOWER
23. WOODBRIDGE RELAY MAST 1957
24. ALEXANDRIA WASHINGTON MASONIC NAT. MEMORIAL 1984
25. GENTLEMAN D.C. FIRE DEPT. TRAINING CENTER TANK 1970

DESCRIPTIVE REPORT CONTROL RECORD

MAP NO.	STATION NAME	JOB NO.	PH-7012	GEODETIC DATUM N.A. 1927	ORIGINATING ACTIVITY Coastal Mapping Division AMC - Norfolk, VA	
		SOURCE OF INFORMATION (Index)	AEROTRI- ANGULATION POINT NUMBER	COORDINATES IN FEET STATE ZONE	GEOGRAPHIC POSITION φ LATITUDE λ LONGITUDE	REMARKS Forward Back
TP-00319	BELLEVUE, DC FIRE DE- PARTMENT TRAINING CENTER TANK, 1970	G.P. (field) G 14477 Pg. 16		X= Y=	φ 38 49 14.113 ✓ λ 77 00 54.364 ✓	435.2 (1415.0) 1311.5 (136.0)
	MARBURY POINT WHARF LIGHT, 1959	QUAD 380771 STA 1108		X= Y=	φ 38 49 19.415 λ 77 01 48.262	598.7 (1251.5) 1164.2 (283.2)
	UPPER POTOMAC RIVER LIGHT 88, 1959	G.P. Vol. II Pg. 394		X= Y=	φ 38 46 09.632 λ 77 01 52.010	297.0 (1553.2) 1255.6 (192.9)
	ALEXANDRIA, NORTON AND CO. TANK, 1969	G.P. G- 14477 Pg. 21 Unadj.		X= Y=	φ 38 48 45.044 λ 77 02 21.841	1389.0 (461.2) 526.9 (920.7)
	ALEXANDRIA, CITY HALL STEEPLE, GOLD BALL, 1928	G.P. G- 2888 Pg. 125 MD		X= Y=	φ 38 48 19.251 λ 77 02 36.939	593.6 (1256.6) 891.3 (556.5)
	ALEXANDRIA, GRAY CHURCH STEEPLE WITH CROSS, 1928	G.P. G- 2888 Pg. 125 VA		X= Y=	φ 38 48 06.119 λ 77 02 39.688	188.7 (1661.5) 957.7 (490.2)
	ALEXANDRIA, GSA FEDERAL RESERVE CENTER, PEPCO TANK, 1970	G.P. G- 14477 Pg. 17 Unadj.		X= Y=	φ 38 47 48.256 λ 77 02 30.156	1488.0 (362.2) 727.7 (720.3)
	WEST RADIO TOWER (on bldg. near Bellevue)(DC) 1928	G.P. VA, MD & DC MD Pg. 126		X= Y=	φ 38 49 20.379 λ 77 01 35.390	628.4 (1221.7) 853.7 (593.7)
	EAST RADIO TOWER (on bldg. near Bellevue)(DC) 1928	G.P. VA, MD & DC MD Pg. 126		X= Y=	φ 38 49 20.404 λ 77 01 33.118	629.2 (1221.2) 798.9 (648.5)
	TORPEDO PLANT, SMOKE STACK (VA), 1928	G.P. VA, MD & DC MD Pg. 126		X= Y=	φ 38 48 17.918 λ 77 02 24.340	552.5 (1297.6) 587.3 (860.4)
COMPUTED BY A.C. Rauck, Jr.			DATE 2/20/73	COMPUTATION CHECKED BY C.E. Blood		DATE 2/22/73
LISTED BY			DATE	LISTING CHECKED BY		DATE
HAND PLOTTING BY			DATE	HAND PLOTTING CHECKED BY		DATE

DESCRIPTIVE REPORT CONTROL RECORD

MAP NO.	STATION NAME	JOB NO.	SOURCE OF INFORMATION (Index)	AEROTRI- ANGULATION POINT NUMBER	GEODETTIC DATUM N.A. 1927		GEOGRAPHIC POSITION		ORIGINATING ACTIVITY Coastal Mapping Division AMC - Norfolk, VA	
					STATE	ZONE	ϕ LATITUDE	λ LONGITUDE	Forward	Back
TP-00319	ALEXANDRIA, DOME, RED TOP (VA), 1928	PH-7012	G.P. VA, MD & DC MD Pg. 126		X=		ϕ 38 48	36.834	1135.8	(714.3)
					Y=		λ 77 02	44.994	1085.6	(362.1)
POWER, 1948			G.P. VA Vol. I Pg. 770		X=		ϕ 38 49	09.251	285.3	(1564.9)
					Y=		λ 77 02	24.901	600.7	(846.8)
WINGATE, 1970			G.P. (field) G-14477 Pg. 8		X=		ϕ 38 49	21.776	670.6	(1179.6)
					Y=		λ 77 00	38.055	918.0	(529.4)
GODDING, 1901			QUAD 380771 STA 1001		X=		ϕ 38 48	08.587	264.8	(1585.4)
					Y=		λ 77 00	34.612	835.2	(612.7)
BELLWOOD, 1957			G.P. Vol. II VA Pg. 21		X=		ϕ 38 47	31.290	964.9	(885.2)
					Y=		λ 77 04	31.118	751.0	(697.0)
SCOUT, 1928			MD Vol. I Pg. 120		X=		ϕ 38 46	01.621	50.0	(1800.1)
					Y=		λ 77 01	49.502	1195.1	(253.4)
ALEXANDRIA MUNICIPAL TANK, 1969			G.P. (field) G-14477 Pg. 18		X=		ϕ 38 48	59.217	1826.0	(24.2)
					Y=		λ 77 03	06.707	161.8	(1285.7)
QUEEN 2, 1959			G.P. Vol. II MD Pg. 390		X=		ϕ 38 45	13.082	403.4	(1446.7)
					Y=		λ 77 01	35.951	868.1	(580.7)
TEMPLE, 1934			G.P. VA Vol. I Pg. 149		X=		ϕ 38 48	32.087	989.6	(860.6)
					Y=		λ 77 04	04.168	100.6	(1347.1)
DUNN RM 2, 1969			G.P. (field) G-14477 VA Pg. 2		X=		ϕ 38 45	11.493	354.4	(1495.8)
					Y=		λ 77 03	54.941	1326.7	(122.1)
COMPUTED BY C.E. Blood				DATE 3/2/73	COMPUTATION CHECKED BY Brad Foltz					
LISTED BY				DATE	LISTING CHECKED BY					
HAND PLOTTING BY				DATE	HAND PLOTTING CHECKED BY					

DEPARTMENT OF COMMERCE
OFFICE OF COMMERCE ADMINISTRATION

g Division
VA

REMARKS

ward Back

207.7 (1642.5)

277.0 (171.2)

459.1 (1391.1)

330.5 (116.9)

858.3 (991.9)

562.9 (885.1)

821.3 (28.9)

479.6 (967.9)

819.8 (1030.4)

409.7 (38.0)

745.6 (104.2)

620.1 (827.1)

7/2/73

TE

TE

COMPILATION REPORT

TP-00319

31. DELINEATION

Delineation was by the Wild B-8 stereoplotter, using 1:30,000 scale, color infrared photographs. Photography was adequate.

32. CONTROL

See Photogrammetric Plot Report, dated February, 1973

33. SUPPLEMENTAL DATA

None

34. CONTOURS AND DRAINAGE

Contours are inapplicable. Drainage was delineated from office interpretation of the photographs.

35. SHORELINE AND ALONGSHORE DETAILS

The mean high water line and alongshore details were delineated from office interpretation of the photographs.

36. OFFSHORE DETAILS

Photography sufficiently covered the area however, due to the high tide at the time of photography several offshore shoal areas could not be delineated.

37. LANDMARKS AND AIDS

Appropriate copies of Form 76-40 were forwarded to the field editor.

38. CONTROL FOR FUTURE SURVEYS

None

39. JUNCTIONS

See Form 76-36B, Item #5 of the Descriptive Report.

40. HORIZONTAL AND VERTICAL ACCURACY

No statement

46. COMPARISON WITH EXISTING MAPS

A comparison has been made with the following U.S. Geological Survey Quadrangle: ALEXANDRIA, VA-DC-MD, scale 1:24,000, dated 1965, revised 1971.

47. COMPARISON WITH NAUTICAL CHARTS

A comparison has been made with Charts 101 SC, edition 15, dated December 30, 1972 and 560, edition 32, dated February 26, 1972. Each 1:40,000 scale.

ITEMS TO BE APPLIED TO NAUTICAL CHARTS IMMEDIATELY

None

ITEMS TO BE CARRIED FORWARD

None

Submitted by:

Charles Blood

Charles Blood

Carto. Tech., May 24, 1973

Approved:

Albert C. Rauck, Jr.

A.C. Rauck, Jr.

Chief, Coastal Mapping Section, AMC

ADDENDUM TO COMPILATION REPORT

TP-00319

FIELD EDIT:

Field edit was adequate. However, the field editor should not have referred the Compilation office to the boatsheet to resolve the question about the proper delineation of Goose Island since mean high water line delineation is not normally dealt with on the boatsheet and the boatsheet is never made available to the Compilation office.

GEOGRAPHIC NAMES

FINAL NAME SHEET

PH-7012 (~~Potomac~~ River)

TP-00319

Alexandria

Bald Eagle Hill

Barnaby Run

Belle View

Bellevue

Blue Plains

Broad Creek

Cameron Run

Daingerfield Island

District of Columbia

Fox Ferry Point

Goose Island

Hog Island

Hooff Run

Hunting Creek

Huntington

Indian Queen Bluff

Jones Point

Marbury Point

Marlin Forest

Maryland

New Alexandria

Oxon Creek

Oxon Run

Potomac River

Rosier Bluff


Shepherds Landing

Villamay

Virginia

Wellington Heights

Approved by:

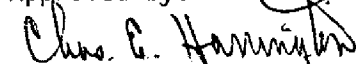

Staff Geographer-C51x2

Chas. E. Harrington

NOAA FORM 75-74
(7-75)U.S. DEPARTMENT OF COMMERCE
NOAA
NATIONAL OCEAN SURVEYPHOTOGRAMMETRIC OFFICE REVIEW
TP - 00319

1. PROJECTION AND GRIDS RRW	2. TITLE RRW	3. MANUSCRIPT NUMBERS X X	4. MANUSCRIPT SIZE X X
CONTROL STATIONS			
5. HORIZONTAL CONTROL STATIONS OF THIRD-ORDER OR HIGHER ACCURACY RRW	6. RECOVERABLE HORIZONTAL STATIONS OF LESS THAN THIRD-ORDER ACCURACY (Topographic stations) NA		7. PHOTO HYDRO STATIONS
8. BENCH MARKS NA	9. PLOTTING OF SEXTANT FIXES X X	10. PHOTOGRAMMETRIC PLOT REPORT X X	11. DETAIL POINTS X X
ALONGSHORE AREAS (Nautical Chart Data)			
12. SHORELINE RRW	13. LOW-WATER LINE X X	14. ROCKS, SHOALS, ETC. RRW	15. BRIDGES RRW
16. AIDS TO NAVIGATION RRW	17. LANDMARKS RRW	18. OTHER ALONGSHORE PHYSICAL FEATURES RRW	19. OTHER ALONGSHORE CULTURAL FEATURES RRW
PHYSICAL FEATURES			
20. WATER FEATURES RRW		21. NATURAL GROUND COVER NA	22. PLANETABLE CONTOURS NA
23. STEREOSCOPIC INSTRUMENT CONTOURS NA	24. CONTOURS IN GENERAL NA	25. SPOT ELEVATIONS NA	26. OTHER PHYSICAL FEATURES RRW
CULTURAL FEATURES			

FIELD EDIT REPORT

TP-00319

Upper Potomac River
Maryland-Virginia51. METHODS

All work was done in accordance with Provisional Photogrammetry Instructions-Field Edit Surveys, current photo-instructions, and project instructions.

An inspection of all shoreline and alongshore features was made, and all deletions, additions, and corrections are either shown or referred to on the field edit paper ozalid. All field edit notes are in purple ink for additions and corrections are in green ink for deletions.

Searches by boat for reported features below the mean high water line (eg. wrecks, piling, rocks) were made. Because of the limited visibility into the water and lack of wire drag gear, any negative findings noted in the field edit data should not be considered conclusive, unless otherwise stated. The latest hydrographic survey of the area should be consulted for more complete information.

Most of the field edit inspection was accomplished by boat. Features were located by either sextant fixes, planetable, or photo identification.

52. ADEQUACY OF COMPILATION

Compilation of shoreline and alongshore features was generally adequate, with the exception that some areas were compiled including overhanging trees. Some areas of overhanging trees are indicated on the field edit ozalid and on the manuscript. A check of the shoreline compilation is recommended.

One question regarding an island and obstruction on the west side of the river near New Alexandria is answered by photos showing both island and obstruction.

At Marbury Point, the dock being built at the time of photography is charted on chart 560, however a shoreline change is to be noted on the manuscript.

Goose Island and the shoals adjoining were compiled by the hydro party at the time of field edit; the hydrographic boat-sheet should be referred to for these areas as noted on the field edit ozalid.

54. RECOMMENDATIONS

None

56. GEOGRAPHIC NAMES

No discrepancies were found while editing this sheet.

57. LANDMARKS AND AIDS TO NAVIGATION

Navigational lights to be charted include Marbury Point Wharf light, 1959 and Upper Potomac River Light 88, 1959. One light, Four Mile Run Leading Light, is to be deleted.

Fourteen landmarks are recommended to be charted and six landmarks are recommended deleted.

Respectfully submitted,

George W. Jamerson

George W. Jamerson
Lt. NOAA
Chief, Photo Party 61
November 1, 1974

2000 - 2013

[illegible]

RESPONSIBLE PERSONNEL		ORIGINATOR
TYPE OF ACTION	NAME	
OBJECTS INSPECTED FROM SEAWARD		☐ PHOTO FIELD PARTY ☐ HYDROGRAPHIC PARTY ☐ GEODETIC PARTY ☐ OTHER (Specify)
POSITIONS DETERMINED AND/OR VERIFIED		FIELD ACTIVITY REPRESENTATIVE
FORMS ORIGINATED BY QUALITY CONTROL AND REVIEW GROUP AND FINAL REVIEW ACTIVITIES	A.L. Shands	☒ REVIEWER ☐ QUALITY CONTROL AND REVIEW GROUP REPRESENTATIVE

INSTRUCTIONS FOR ENTRIES UNDER 'METHOD AND DATE OF LOCATION'

(Consult Photogrammetric Instructions No. 64,

OFFICE

I. OFFICE IDENTIFIED AND LOCATED OBJECTS

Enter the number and date (including month, day, and year) of the photograph used to identify and locate the object.

EXAMPLE: 75E(C)6042
8-12-75

FIELD

I. NEW POSITION DETERMINED OR VERIFIED

Enter the applicable data by symbols as follows:

- F - Field
- L - Located
- V - Verified
- 1 - Triangulation
- 2 - Traverse
- 3 - Intersection
- 4 - Resection
- 5 - Field identified
- 6 - Theodolite
- 7 - Planetable
- 8 - Sextant

A. Field positions* require entry of method of location and date of field work.

EXAMPLE: F-2-6-L
8-12-75

*FIELD POSITIONS are determined by field observations based entirely upon ground survey methods.

FIELD (Cont'd)

B. Photogrammetric field positions** require entry of method of location or verification, date of field work and number of the photograph used to locate or identify the object.

EXAMPLE: P-8-V
8-12-75
74L(C)2982

II. TRIANGULATION STATION RECOVERED

When a landmark or aid which is also a triangulation station is recovered, enter 'Triang. Rec.' with date of recovery.

EXAMPLE: Triang. Rec.
8-12-75

III. POSITION VERIFIED VISUALLY ON PHOTOGRAPH

Enter 'V-Vis.' and date.

EXAMPLE: V-Vis.
8-12-75

**PHOTOGRAMMETRIC FIELD POSITIONS are dependent entirely, or in part, upon control established by photogrammetric methods.

REVIEW REPORT TP-00319

SHORELINE MAP

January 24, 1977

61. GENERAL STATEMENT:

See Summary which is pages 6a and 6b of this Descriptive Report.

A comparison print showing the differences noted in Paragraphs 62, 63, 64 and 65 is included with the original of this report.

62. COMPARISON WITH REGISTERED TOPOGRAPHIC SURVEYS:

A comparison was made with Topographic Maps T-5756 and T-5757, each 1:10,000 scale, dated 1940 and 1939 respectively and Planimetric Surveys T-8605 and T-8606, 1:4,800 scale, dated 1948. These are the latest registered surveys of the area. Extensive differences in the shoreline configuration were noted and shown on the comparison print in blue pencil.

In the area compared, TP-00319 supersedes the above mentioned surveys for nautical chart construction purposes.

63. COMPARISON WITH MAPS OF OTHER AGENCIES:

A comparison was made with U.S.G.S. Quadrangle Alexandria, VA-DC-MD, 1:24,000 scale, dated 1965, photorevised 1971. Significant differences are shown on the comparison print in brown pencil.

64. COMPARISON WITH CONTEMPORARY HYDROGRAPHIC SURVEYS:

A comparison was made with Boatsheets H-9477 (AHP-5-5-74) and H-9479 (AHP-10-6-74). No conflicts

were noticed between soundings and the shoreline delineation. However, many rocks, wrecks and piles positioned by the hydrographer are not visible on the photographs due to cloudy water conditions and the stage of tide at the time of photography. These are shown on the comparison print in purple pencil.

65. COMPARISON WITH NAUTICAL CHARTS:

A comparison was made with Chart 12289, 1:40,000 scale, 36th edition; dated March 6, 1976. Significant differences are noted on the comparison print in red pencil.

66. ADEQUACY OF RESULTS AND FUTURE SURVEYS:

This map complies with the project instructions and meets the requirements of Bureau Standards and the National Standards of Map Accuracy.

Submitted by:

A. L. Shands

A. L. Shands
Cartographer

Approved for forwarding:

Joseph W. Vonasek

Joseph W. Vonasek
Chief, Photogrammetric Branch, AMC


Approved:

[Signature]


Chief, Photogrammetric Branch

[Signature]

Chief, Coastal Mapping Div.

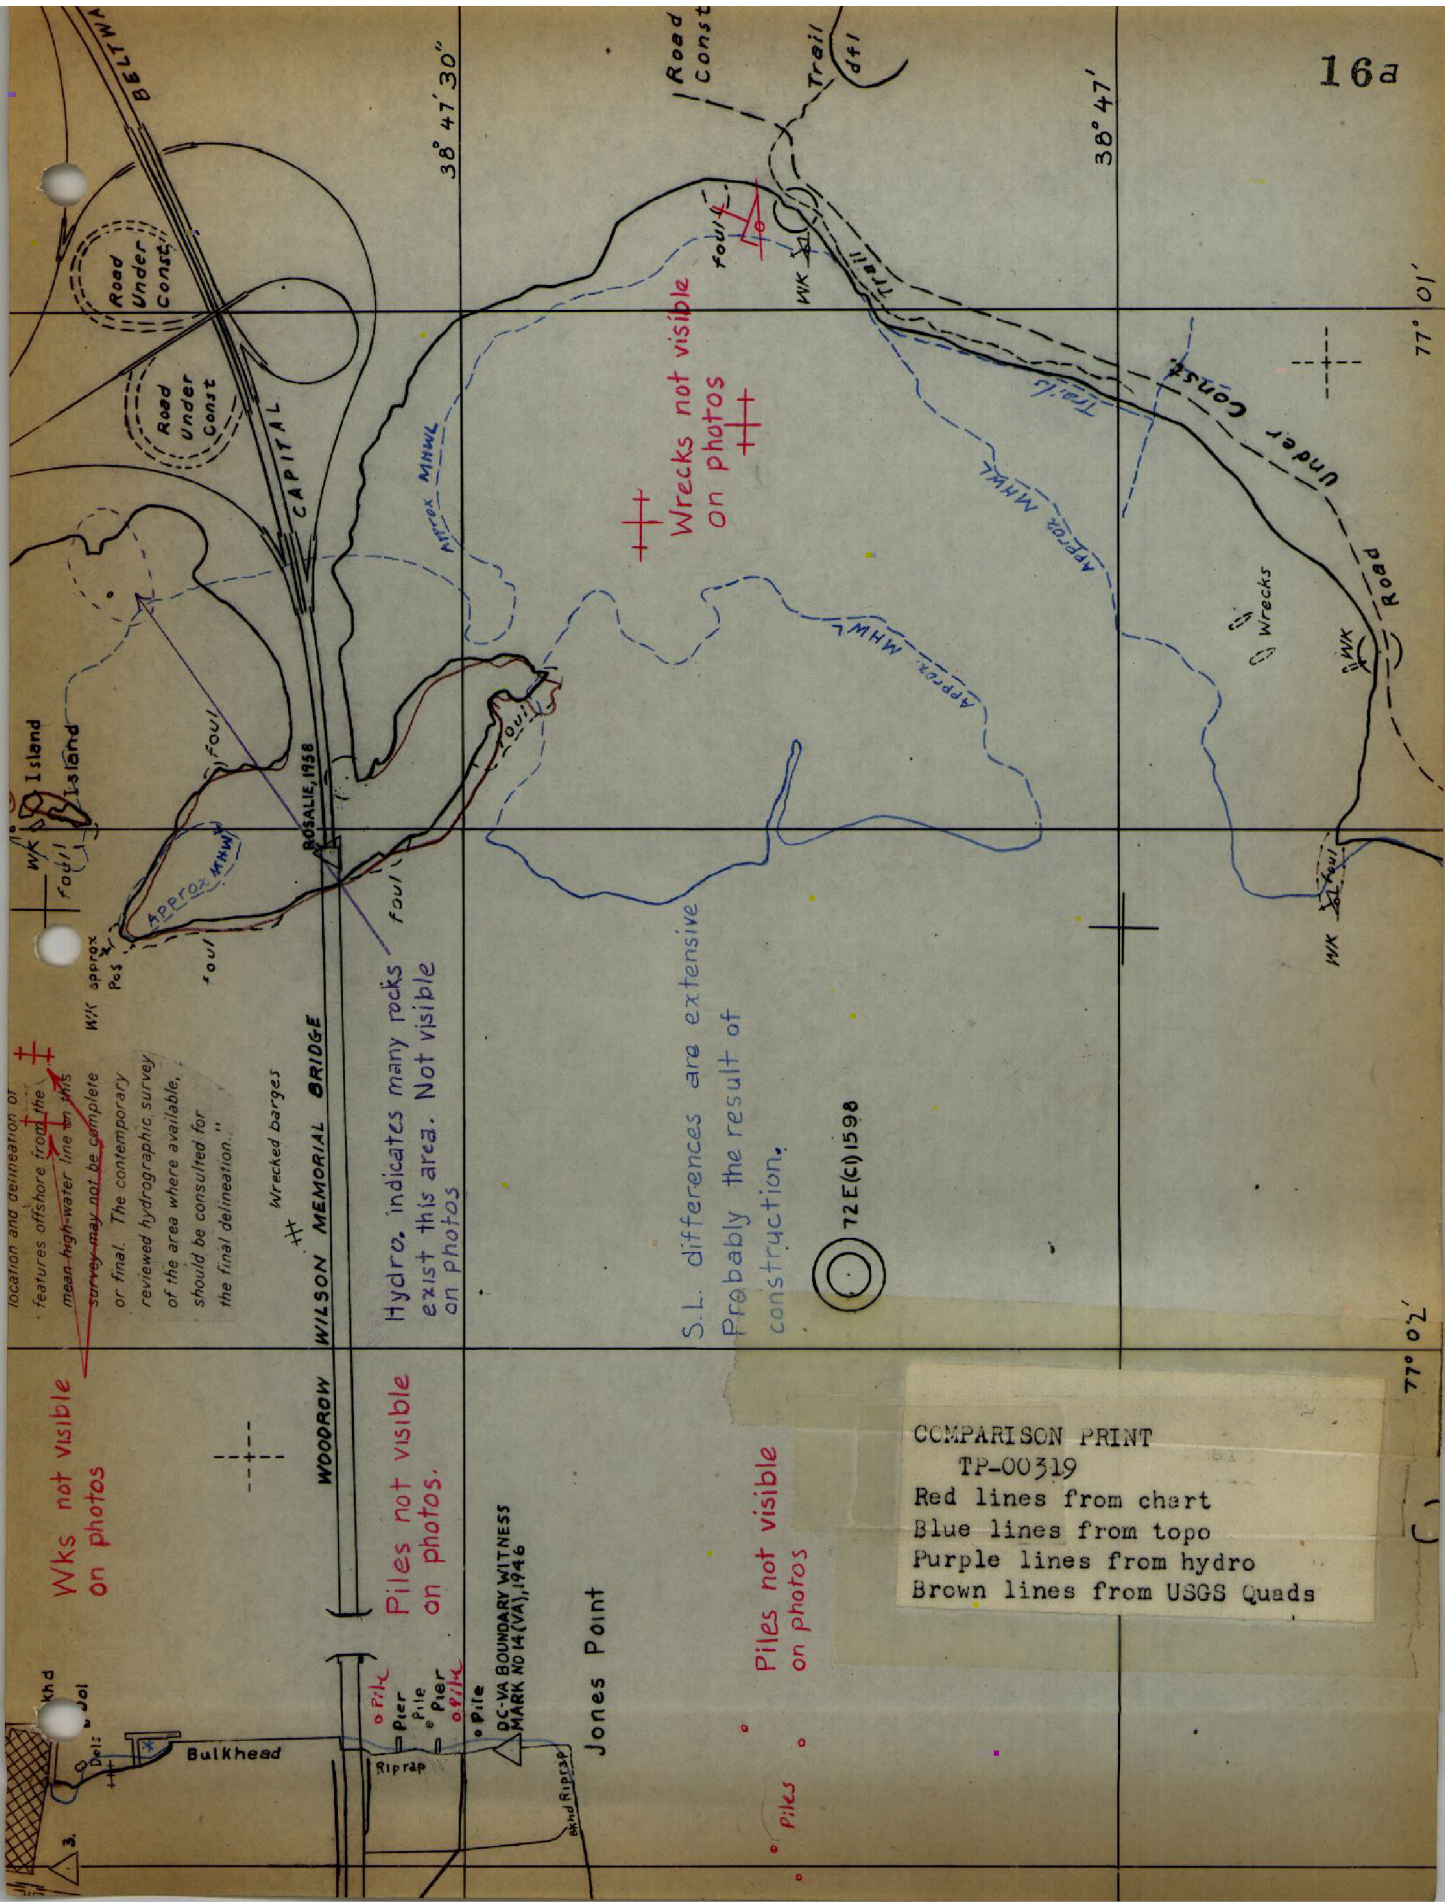

COMPARISON PRINT
TP-00319
Red lines from chart
Blue lines from topo
Purple lines from hydro
Brown lines from USGS Quads

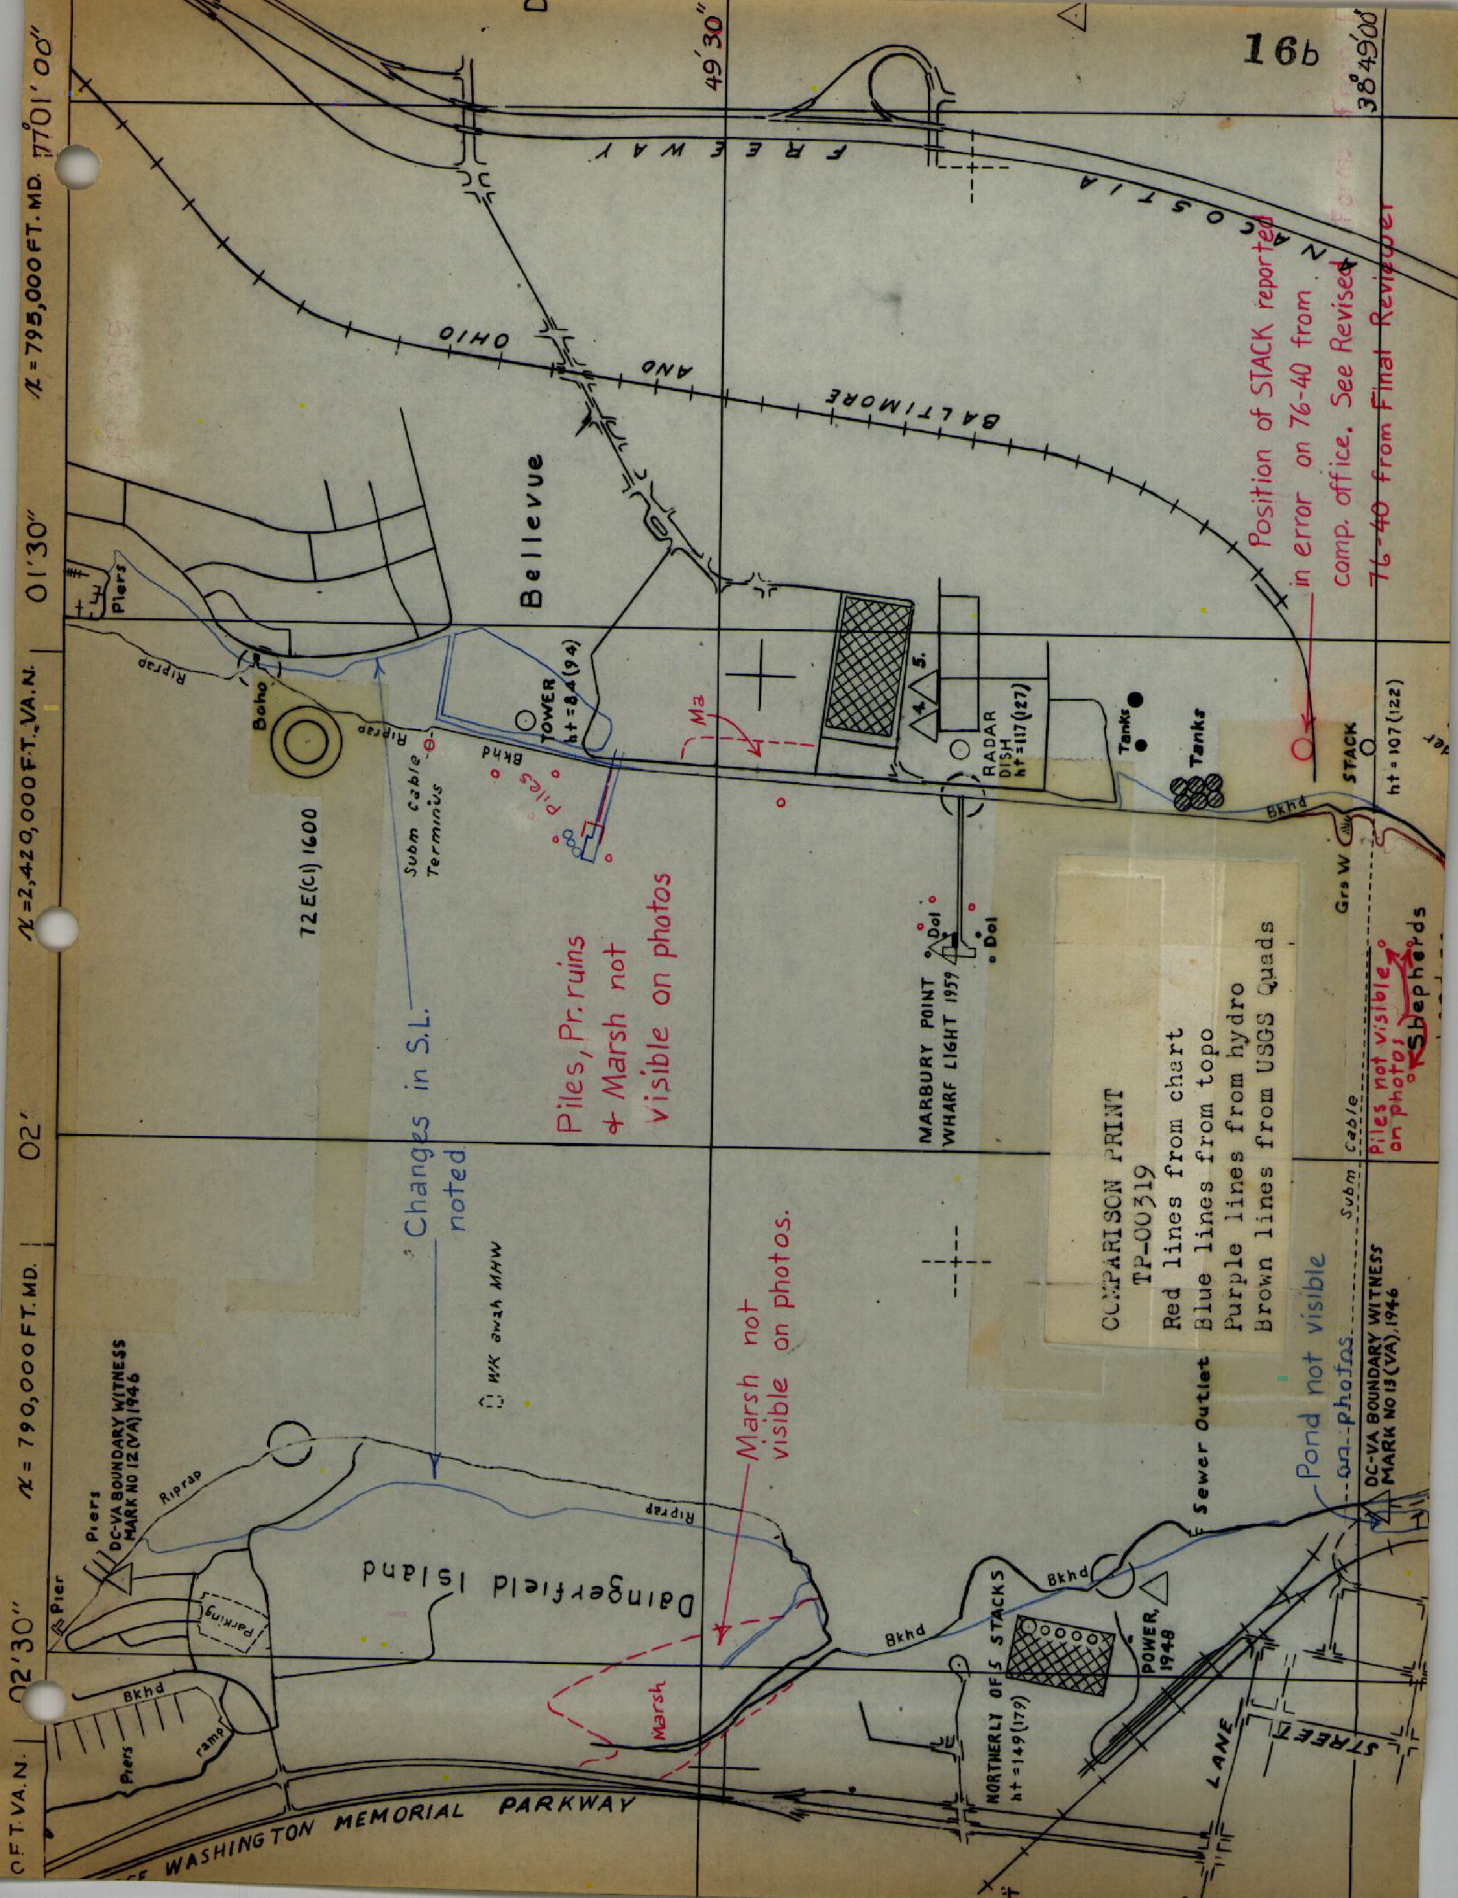

16c

Pile 10

Piles not visible on photos

Pile

Pile 2

Pile

Piling

Island not visible on photos

Island not visible on photos

T2E (C1) 1646

BELL HAVEN FAIRFAX CO.
TANK, 1969 ht = 92 (242)

S.L. changes due to construction.

COMPARISON PRINT

TP-00319

Red lines from chart

Blue lines from topo

Purple lines from hydro

Brown lines from USGS Quads

38° 47' 00"

77° 04' 00"

38° 48' 00"

77° 03' 00"

FRANKLIN STREET

GREEN STREET

WASHINGTON STREET

COLUMBUS STREET

ALFRED STREET

STACK
ht = 187 (217)foul
with stumps

Pond

Ovhd. Cab.

HIGHWAY

JEFFERSON DAVIS

Hooft Run

CAPITAL BELTWAY

RUN

AVENUE

ton

MHWL

BKG

MHWL

Hunting

pt ruins

Creek


COMPARISON PRINT

TP-00319


Red lines from chart
Blue lines from topo
Purple lines from hydro
Brown lines from USGS Quads

Shoreline delineation subject to varied interpretations based on the water level in these low flat areas.

NOTE: Unlabeled circles are photogrammetric plot points; not map features

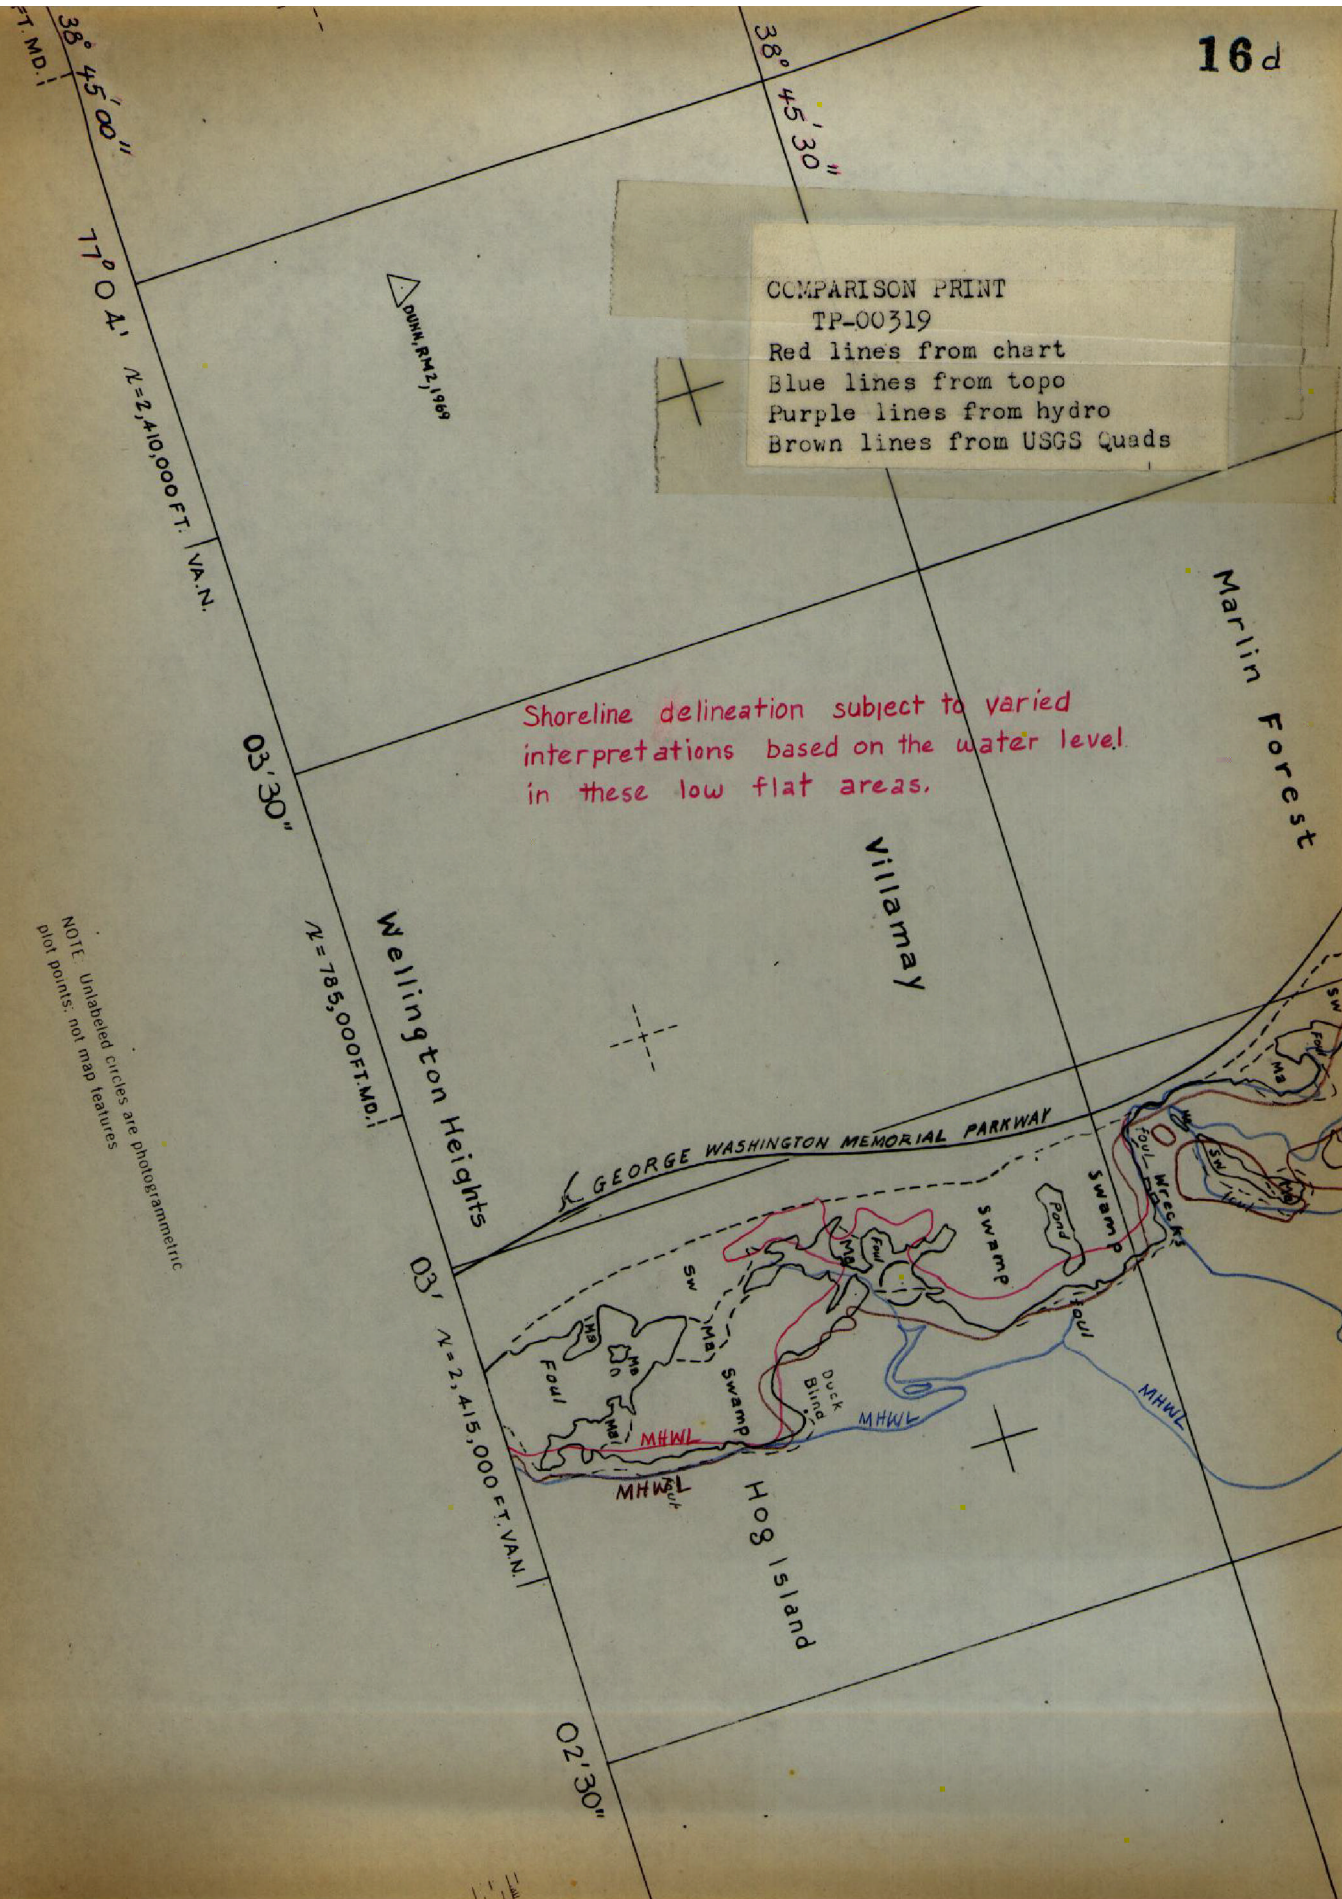


16e

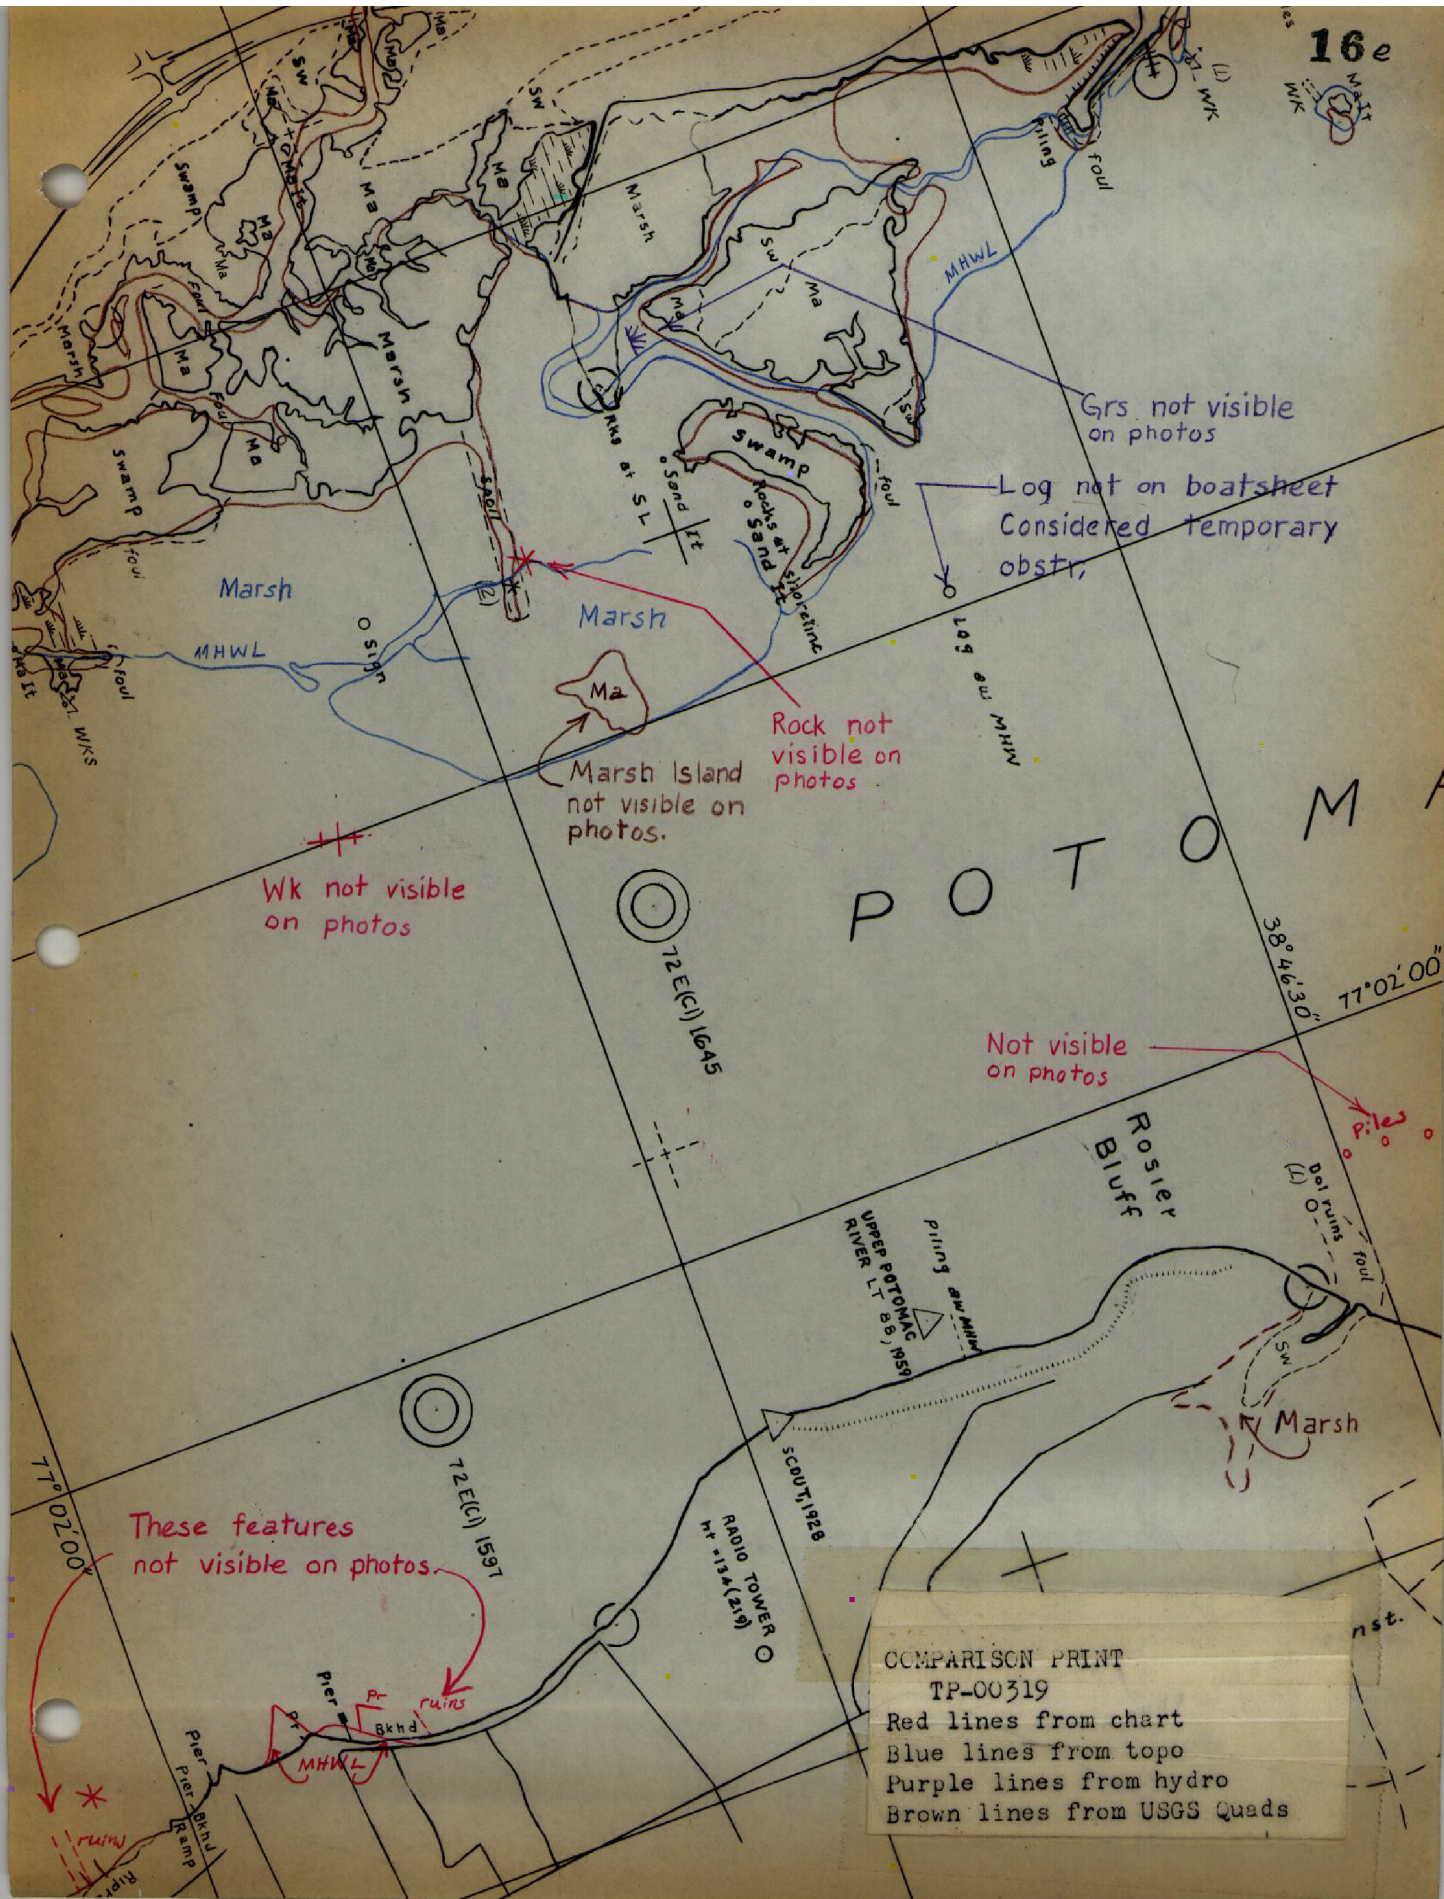

COMPARISON PRINT
TP-00319
Red lines from chart
Blue lines from topo
Purple lines from hydro
Brown lines from USGS Quads

STACK
ht = 140 (164)

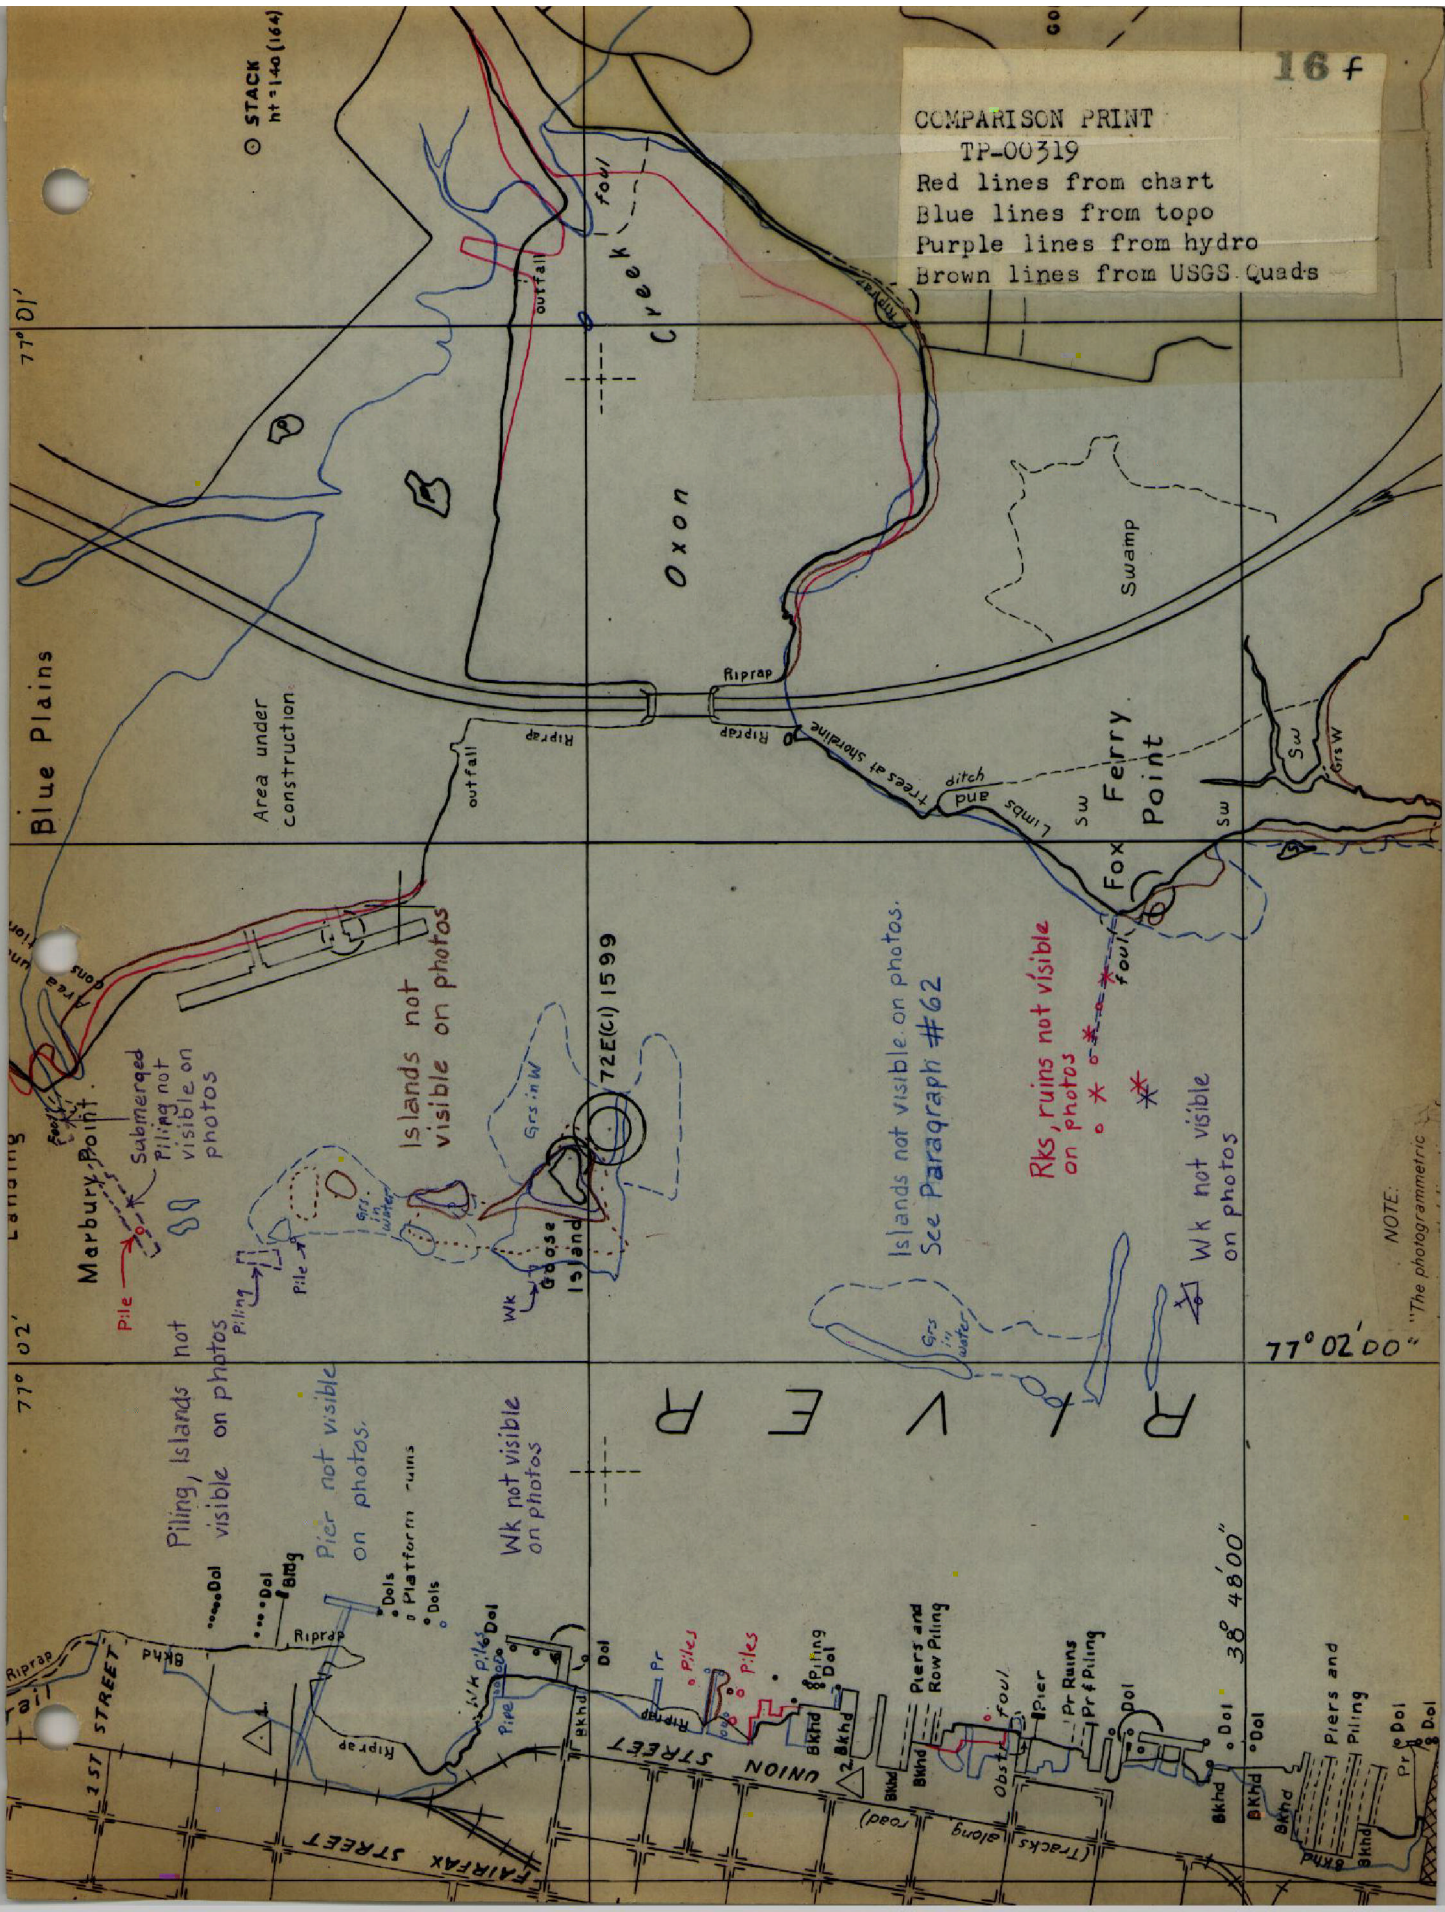

NOTE:
"The photogrammetric

RECORD OF APPLICATION TO CHARTS

FILE WITH DESCRIPTIVE REPORT OF SURVEY NO. TP 00319

INSTRUCTIONS

A basic hydrographic or topographic survey supersedes all information of like nature on the uncorrected chart.

1. Letter all information.
2. In "Remarks" column cross out words that do not apply.
3. Give reasons for deviations, if any, from recommendations made under "Comparison with Charts" in the Review

[illegible]